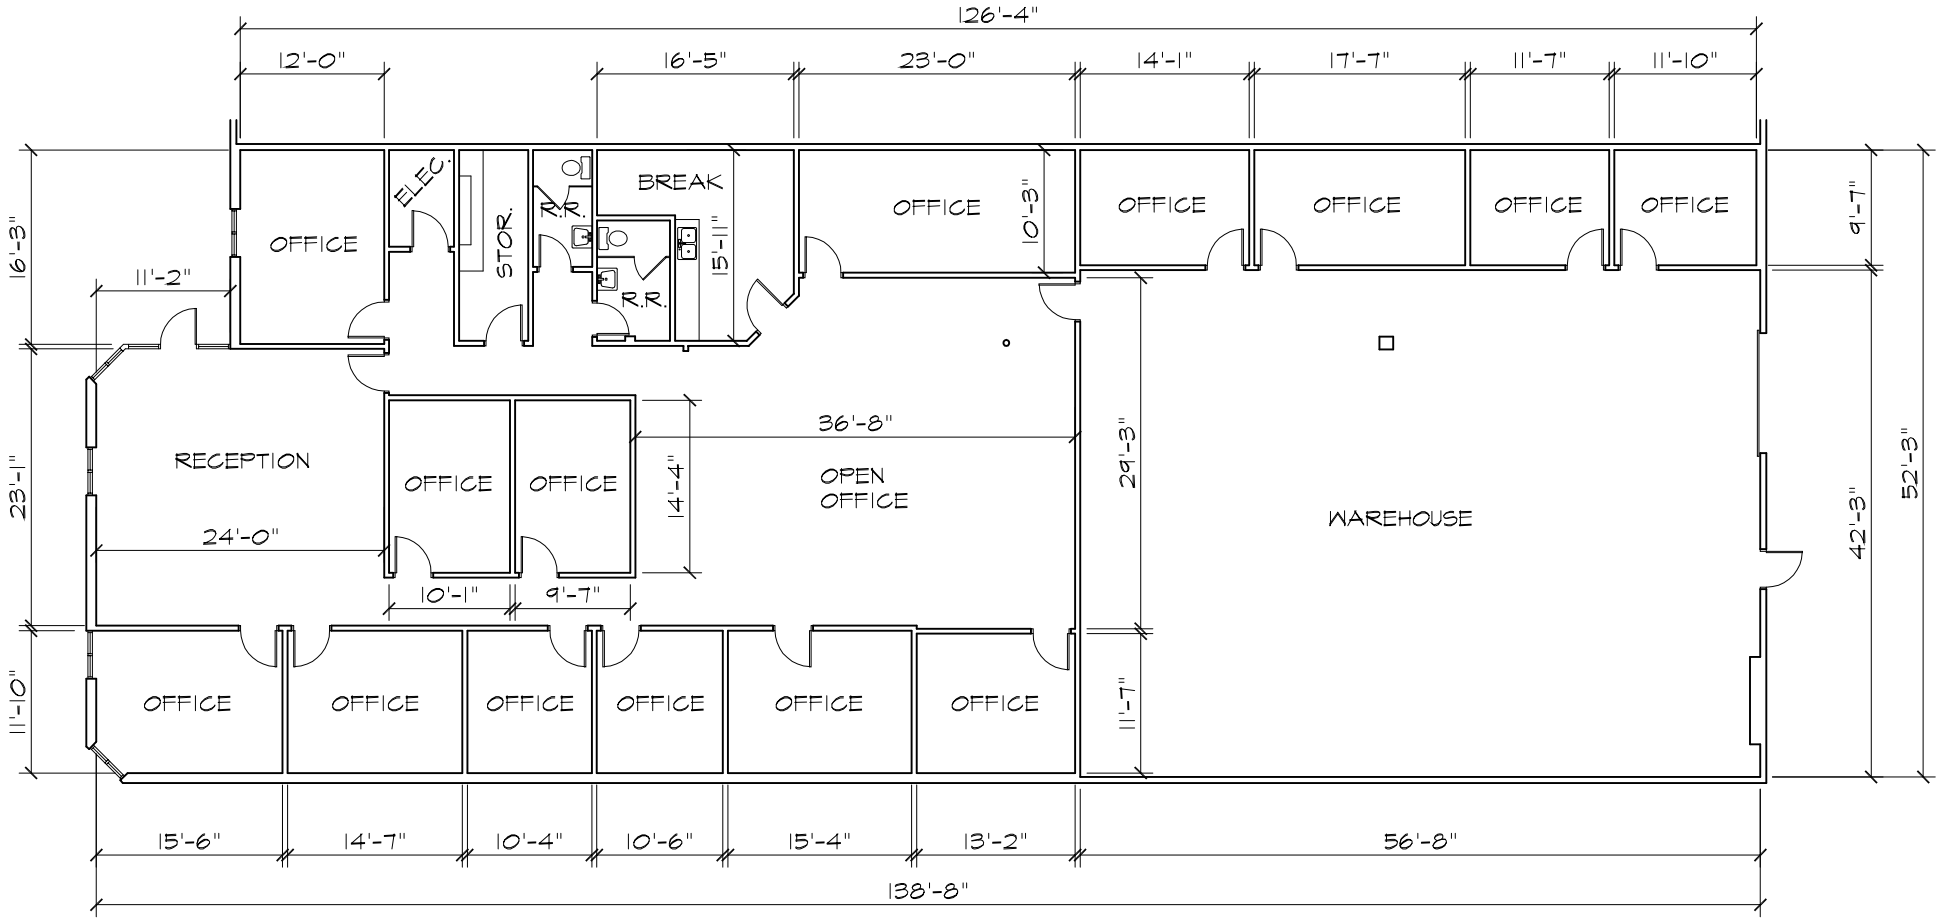

AN AS BUILT FOR: 5/23/08

15107 Surveyor Blvd.

ADDISON, TX 75001
7,200 SF

SCALE: 1/16" = 1'-0"

Kevin P. Simon

P.O. Box 100
Mabank, TX 75147
903.880.6636

kevin@kevinpsimon.net

FOR MORE INFORMATION CONTACT:

TOM LUCAS
RICH YOUNG

HARRY B. LUCAS COMPANY
(972) 991-4567